



# QUADRANT

SUITE 220  
2,852 RSF

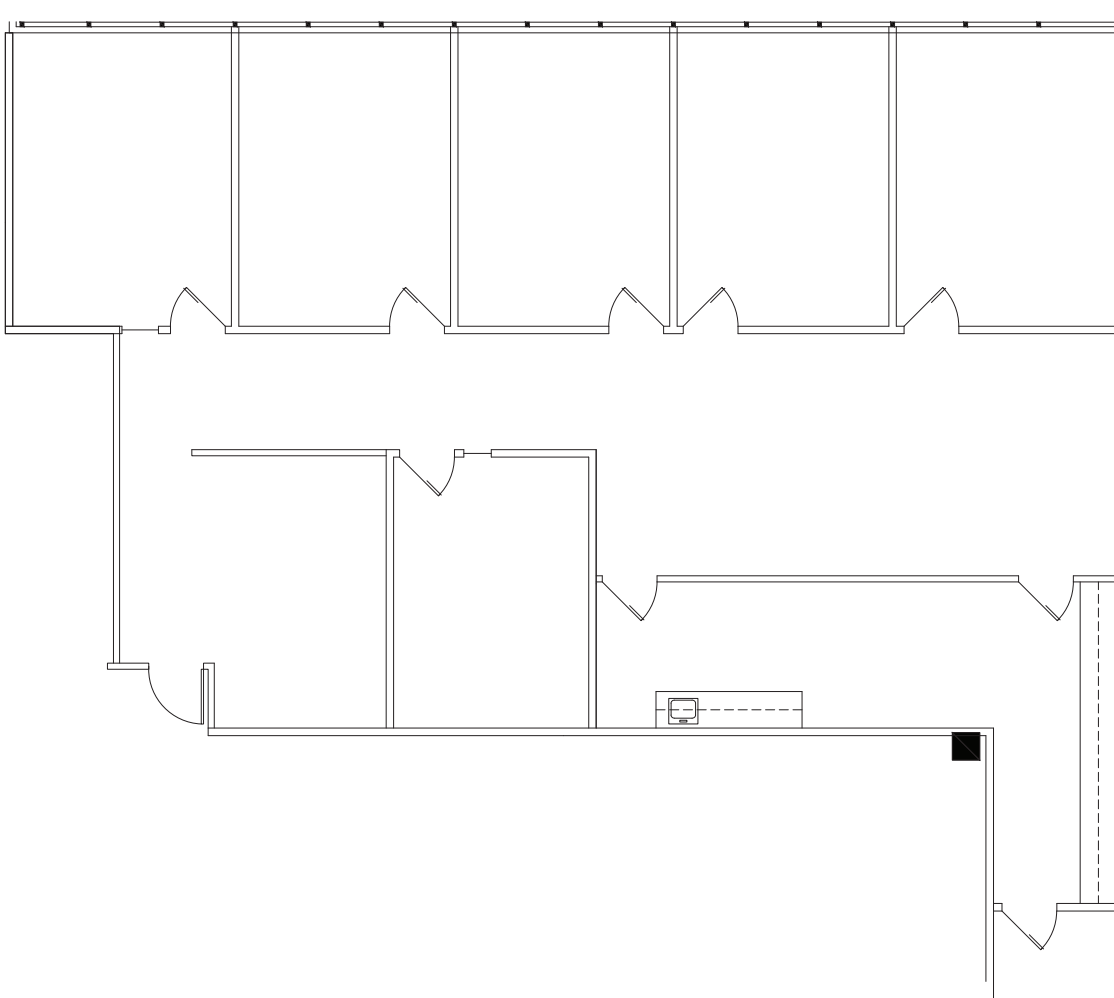

KEY

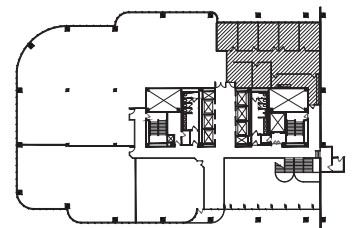

CLASS AA OFFICE FOR LEASE, FOR INFORMATION CONTACT:

W. Ryan Stout  
303.813.6448  
ryan.stout@cushwake.com

Zachary T. Williams  
303.813.6474  
zach.williams@cushwake.com

Caitlin I. Ellenson  
303.312.1914  
caitlin.ellenson@cushwake.com

