


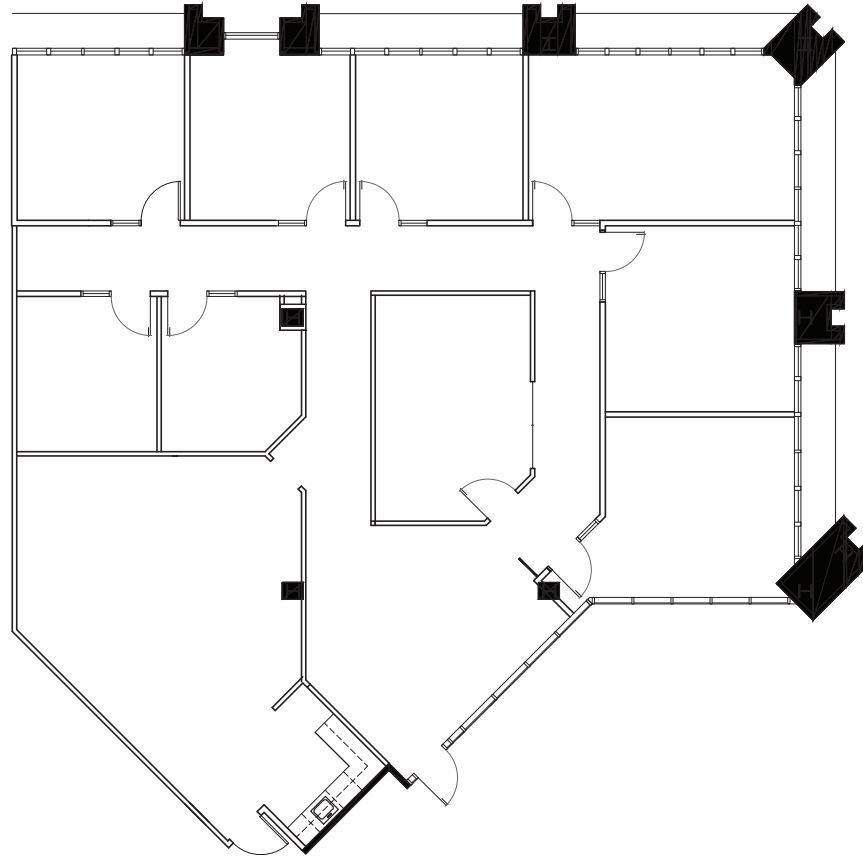

AVENUE
WEST

Suite 200 | 3,655 SF



For more information, please contact:



William B. Lucas
Managing Director
Direct: +1 303 312 4239
bill.lucas@cushwake.com

W. Ryan Stout
Managing Director
+1 303 886 3327
ryan.stout@cushwake.com

Zachary T. Williams
Director
+1 303 813 6474
zach.williams@cushwake.com

Caitlin I. Ellenson
Director
+1 303 312 3327
caitlin.ellenson@cushwake.com