


AS-BUILT

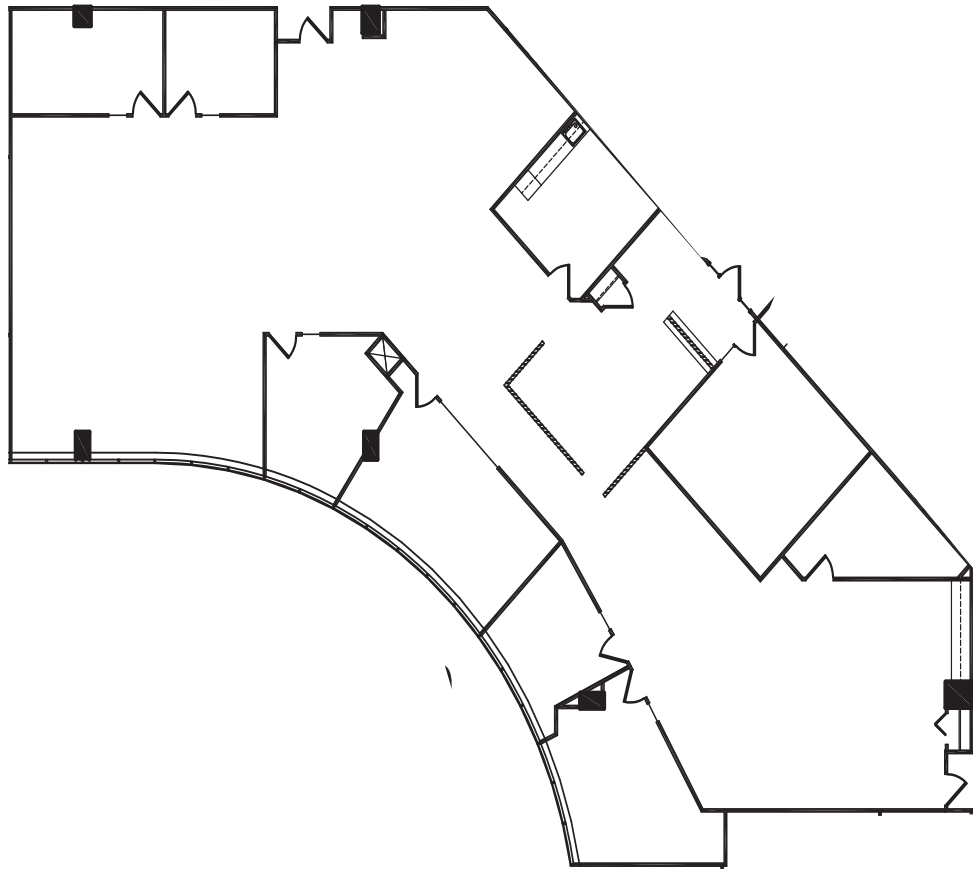

SUITE 203
5,914 RSF