
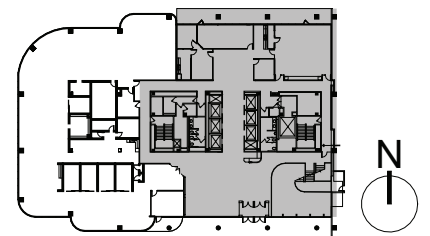


QUADRANT

SUITE 100
11,494 RSF

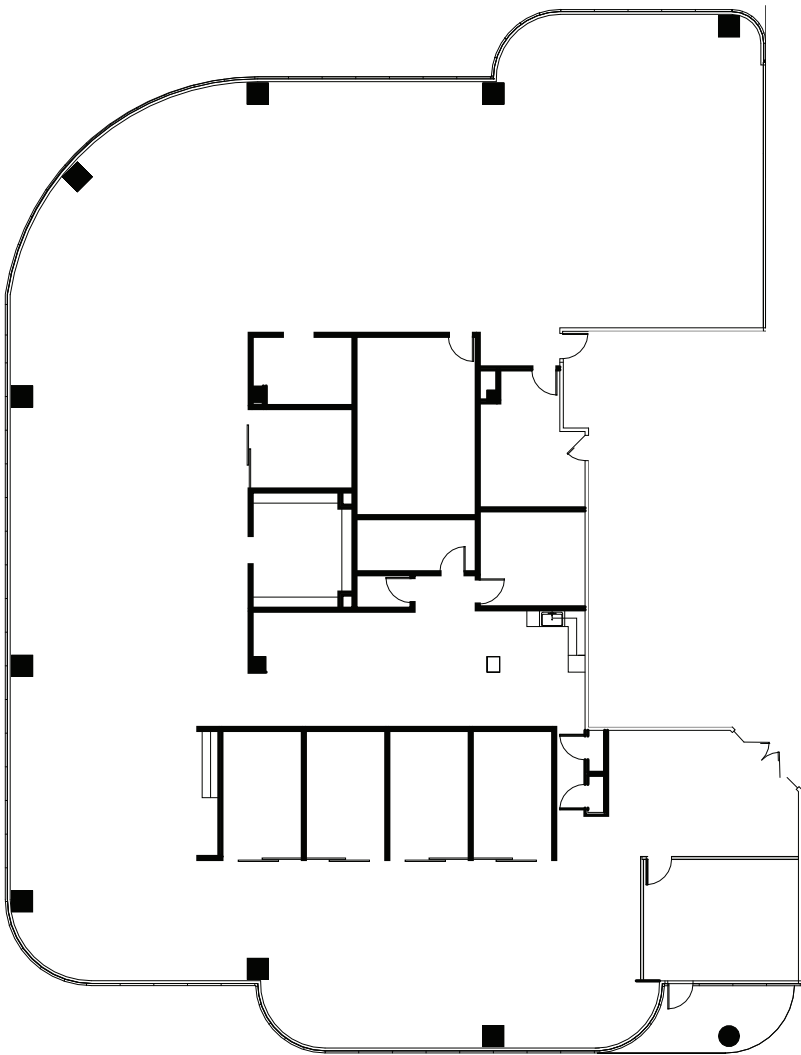

CLASS AA OFFICE FOR LEASE, FOR INFORMATION CONTACT:

W. Ryan Stout
303.813.6448
ryan.stout@cushwake.com

Zachary T. Williams
303.813.6474
zach.williams@cushwake.com

Caitlin I. Ellenson
303.312.1914
caitlin.ellenson@cushwake.com

