



G:\CLIENTS\1155 Elm St. - FIVEFLOOR 5AS BUILT\SHEETS\SHEETS 1155 ELM FL5 VACANT SUITES.dwg 7/13/2026 10:55 AM

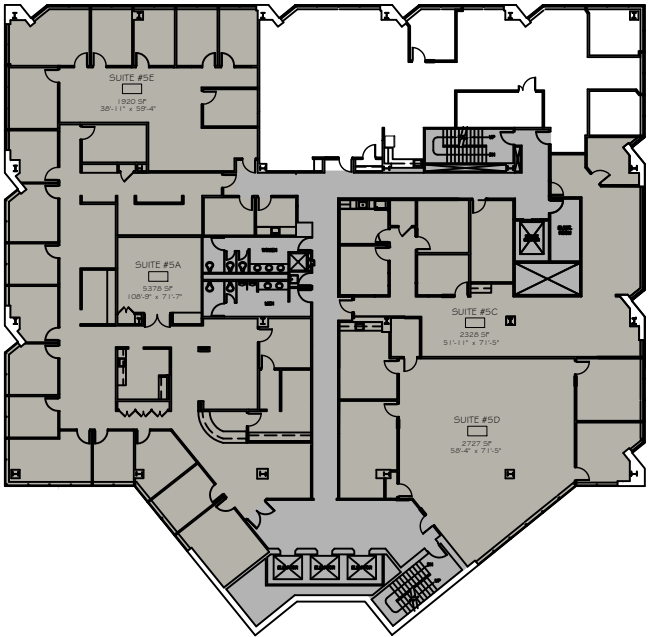

KEY PLAN

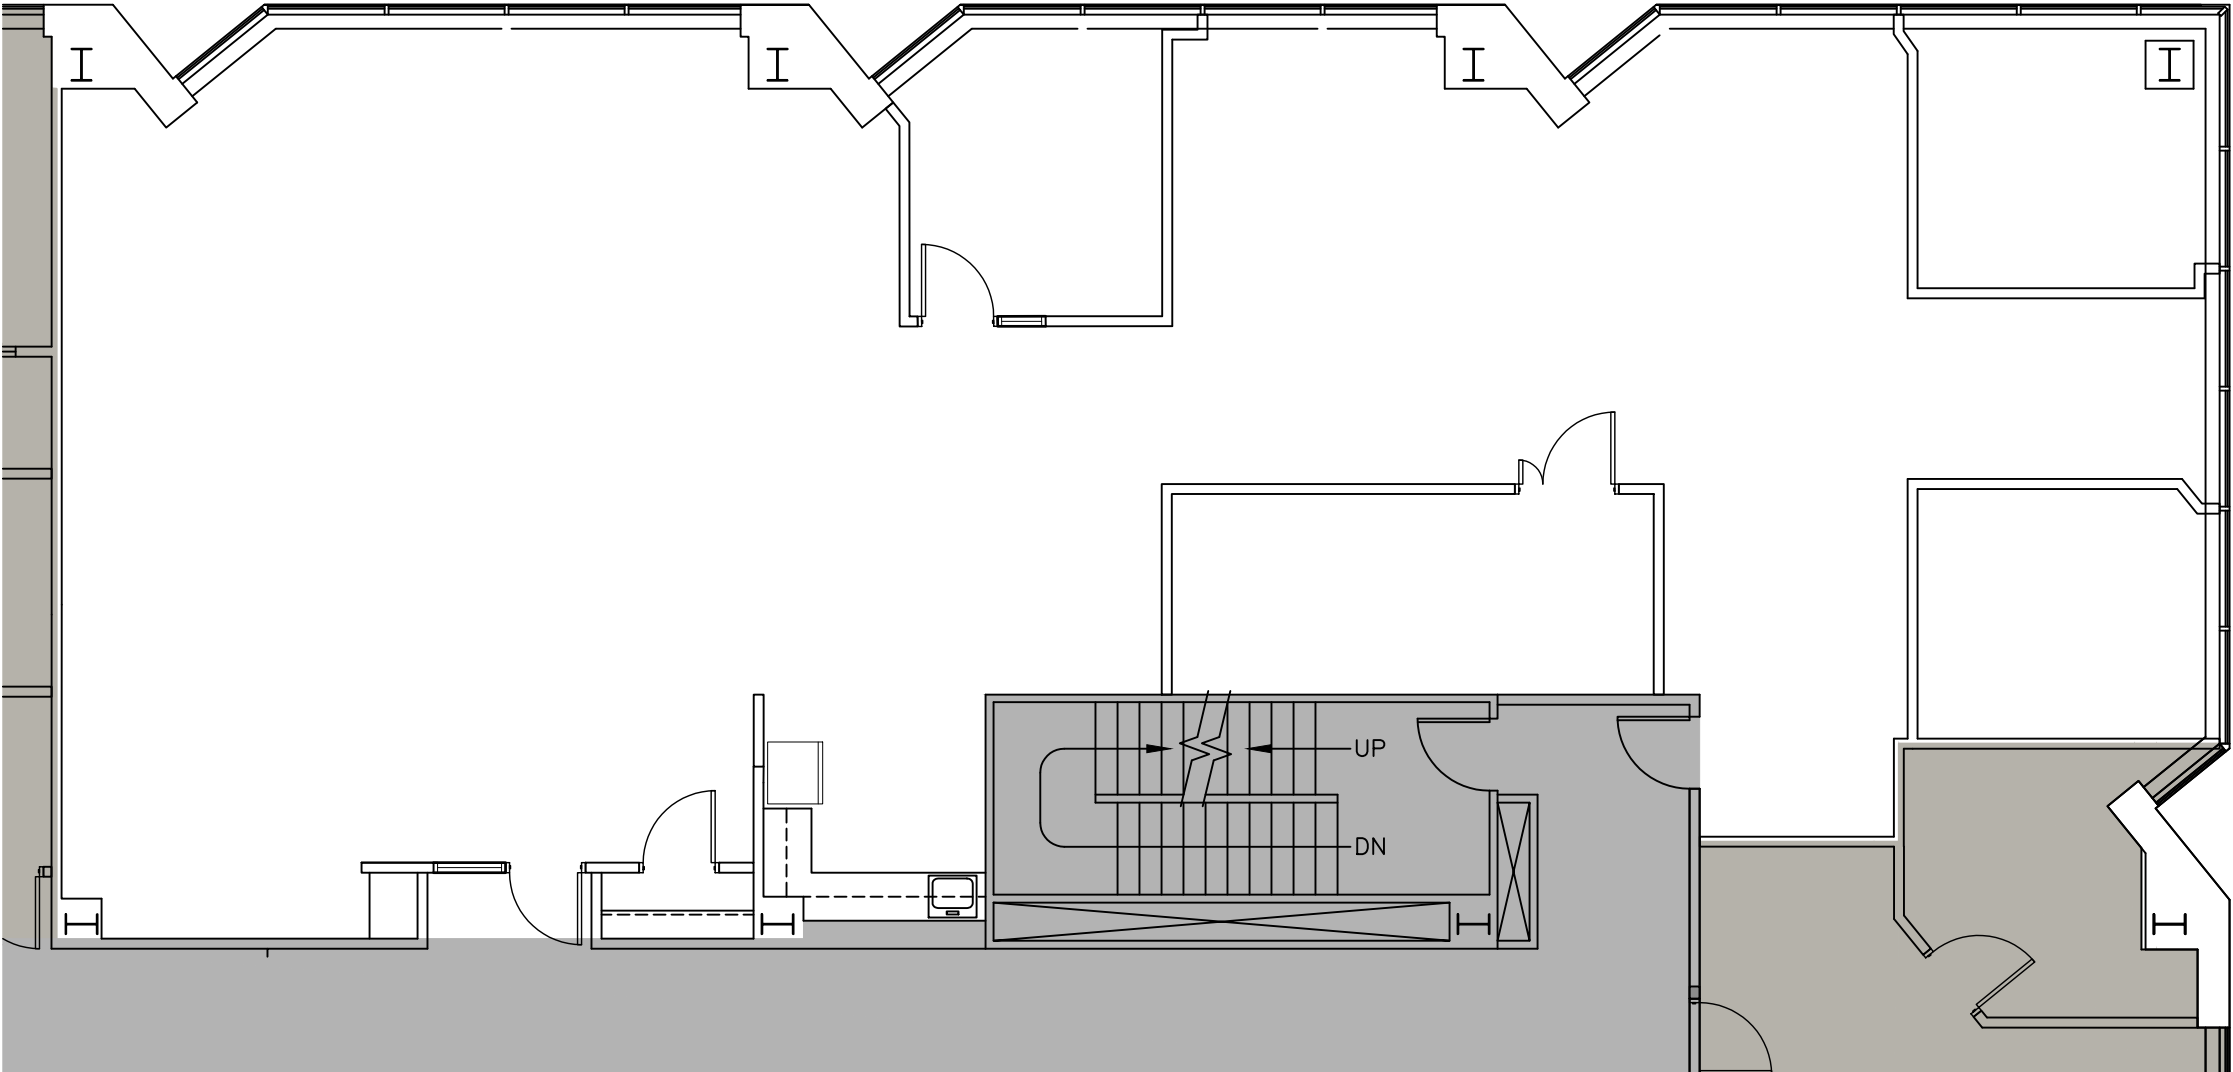

FARLEY | WHITE
INTERESTS



3 Executive Park Drive
Suite 106
Bedford, NH 03110
603.623.8952

1155 ELM STREET, FLOOR 5
SUITE 5B

1155 ELM STREET, MANCHESTER, NH

AS BUILT

DATE: 7/13/2026
SCALE: 1/8" = 1'-0"
DRAWN BY: HP

EX.5B