





CENTER POINT I

3900 E Mexico Avenue,
Denver, CO 80210

SUITE 500 5,437 RSF

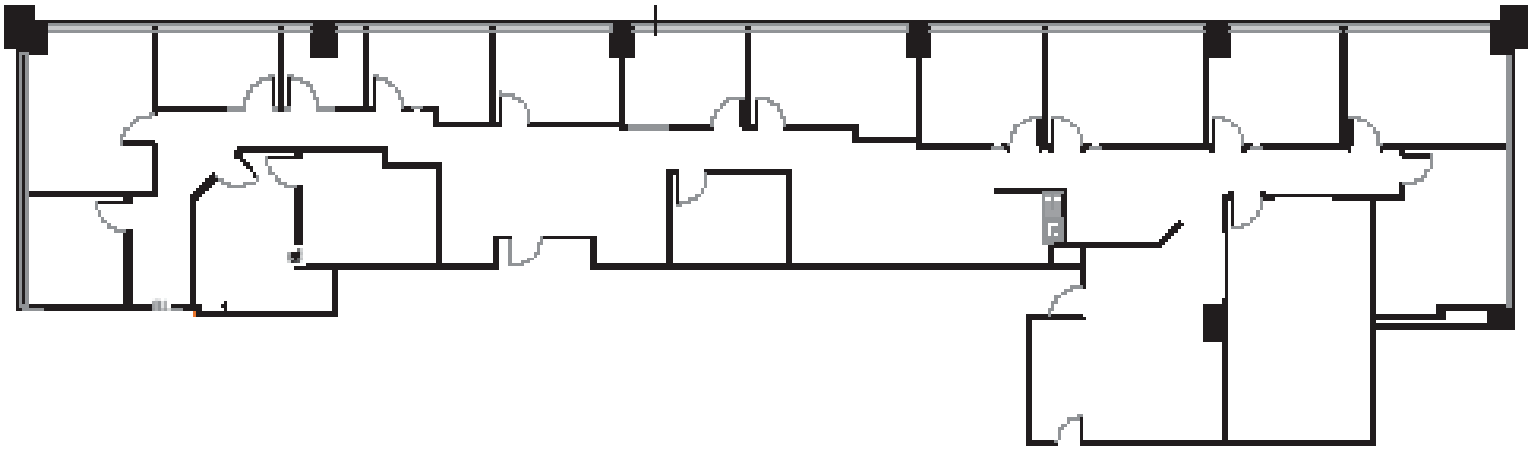

Key

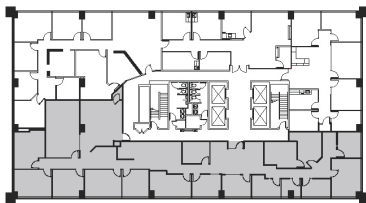

W. Ryan Stout
303.813.6448
ryan.stout@cushwake.com

Zachary T. Williams
303.813.6474
zach.williams@cushwake.com

Caitlin I. Ellenson
303.312.1914
caitlin.ellenson@cushwake.com

