


KEY PLAN

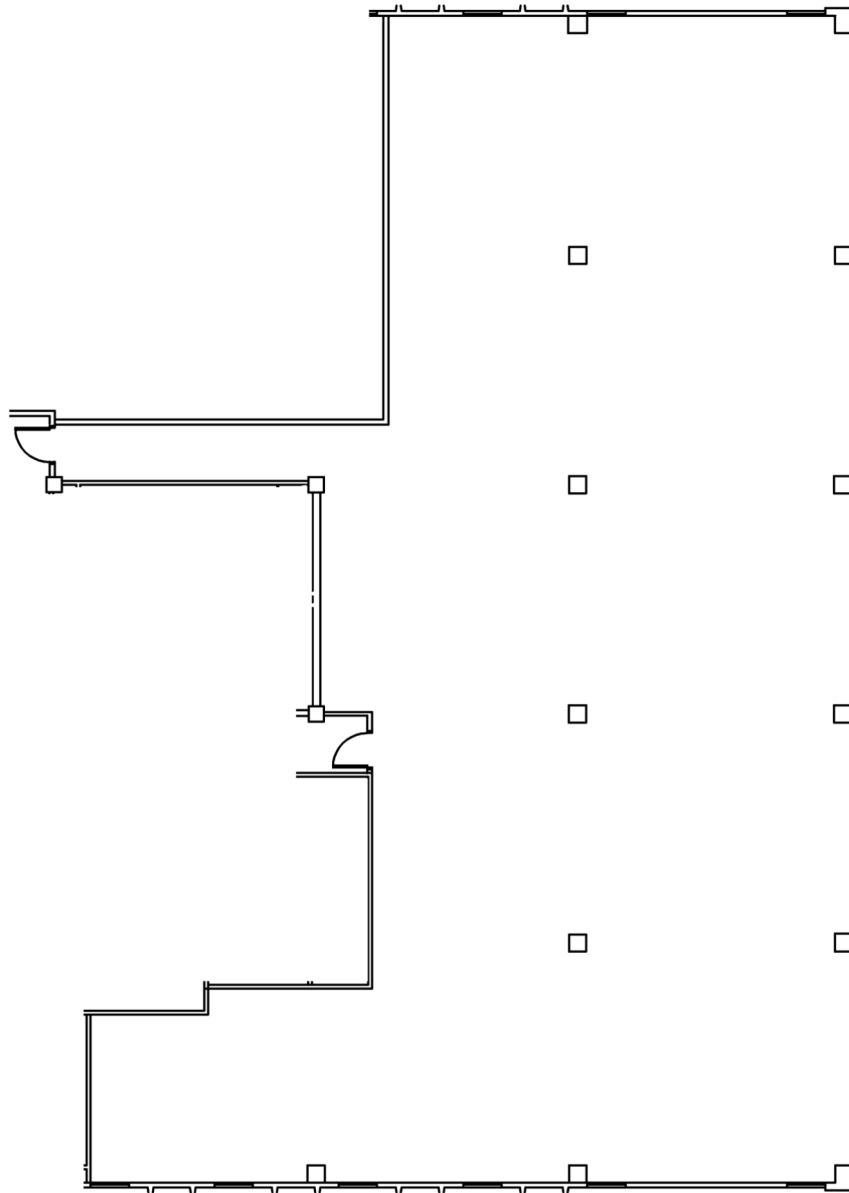

6,398 RENTABLE SQ.FT.
SCALE: NTS

VACANCY

SUITE 350
9102 N. MERIDIAN ST. INDIANAPOLIS, IN



 PARALLEL DESIGN GROUP

2015.509

05.28.21