


SCALE
NOT TO SCALE

AS-BUILT
4TH FLOOR
9102 N MERIDIAN - SUITE 1
INDIANAPOLIS, IN

PROJECT NUMBER
2015.509

DATE | REVISION
11.07.24 | 00

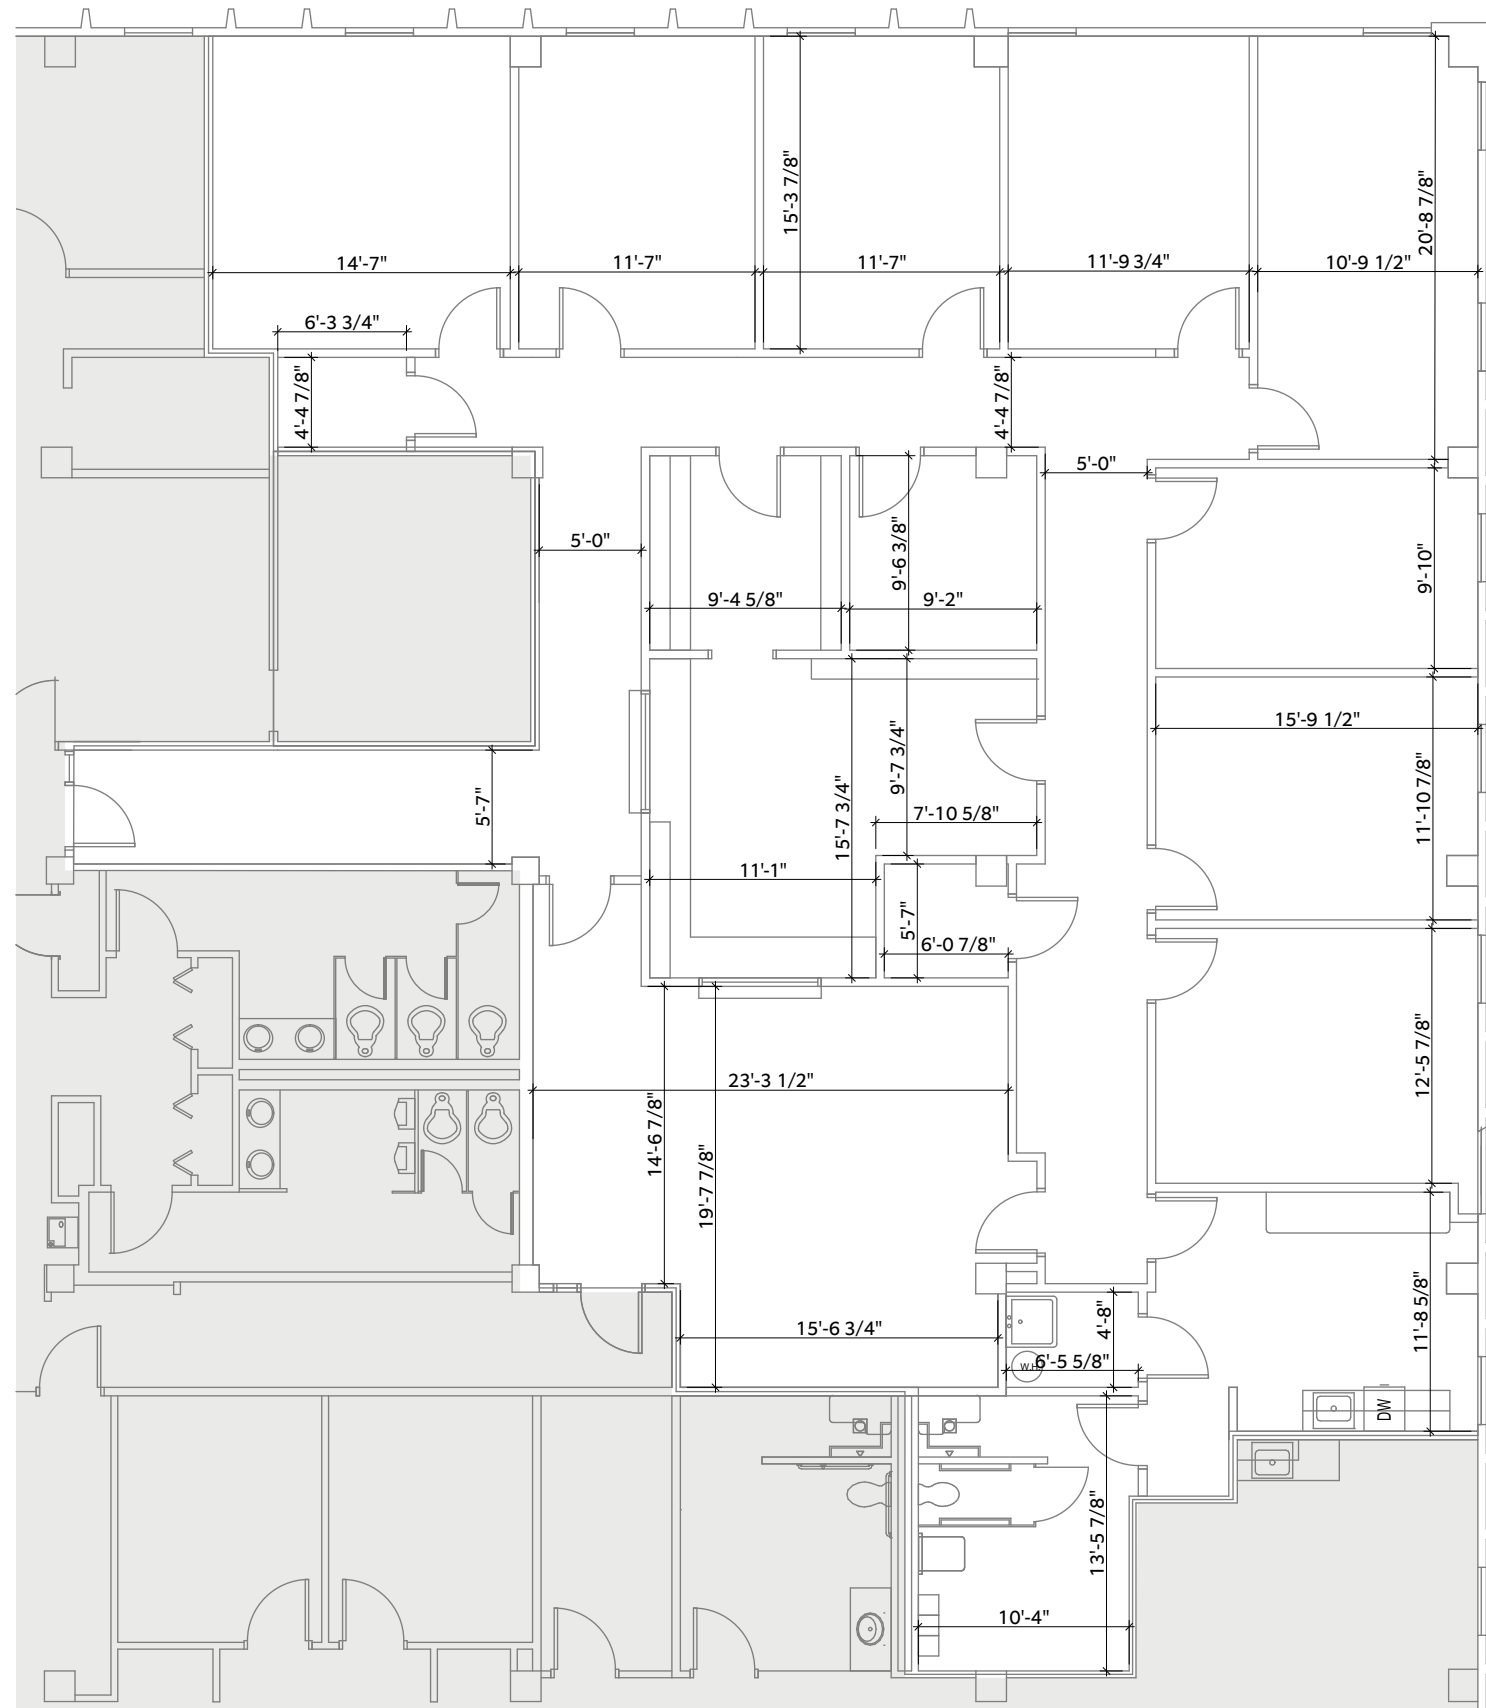

PARALLEL DESIGN GROUP