


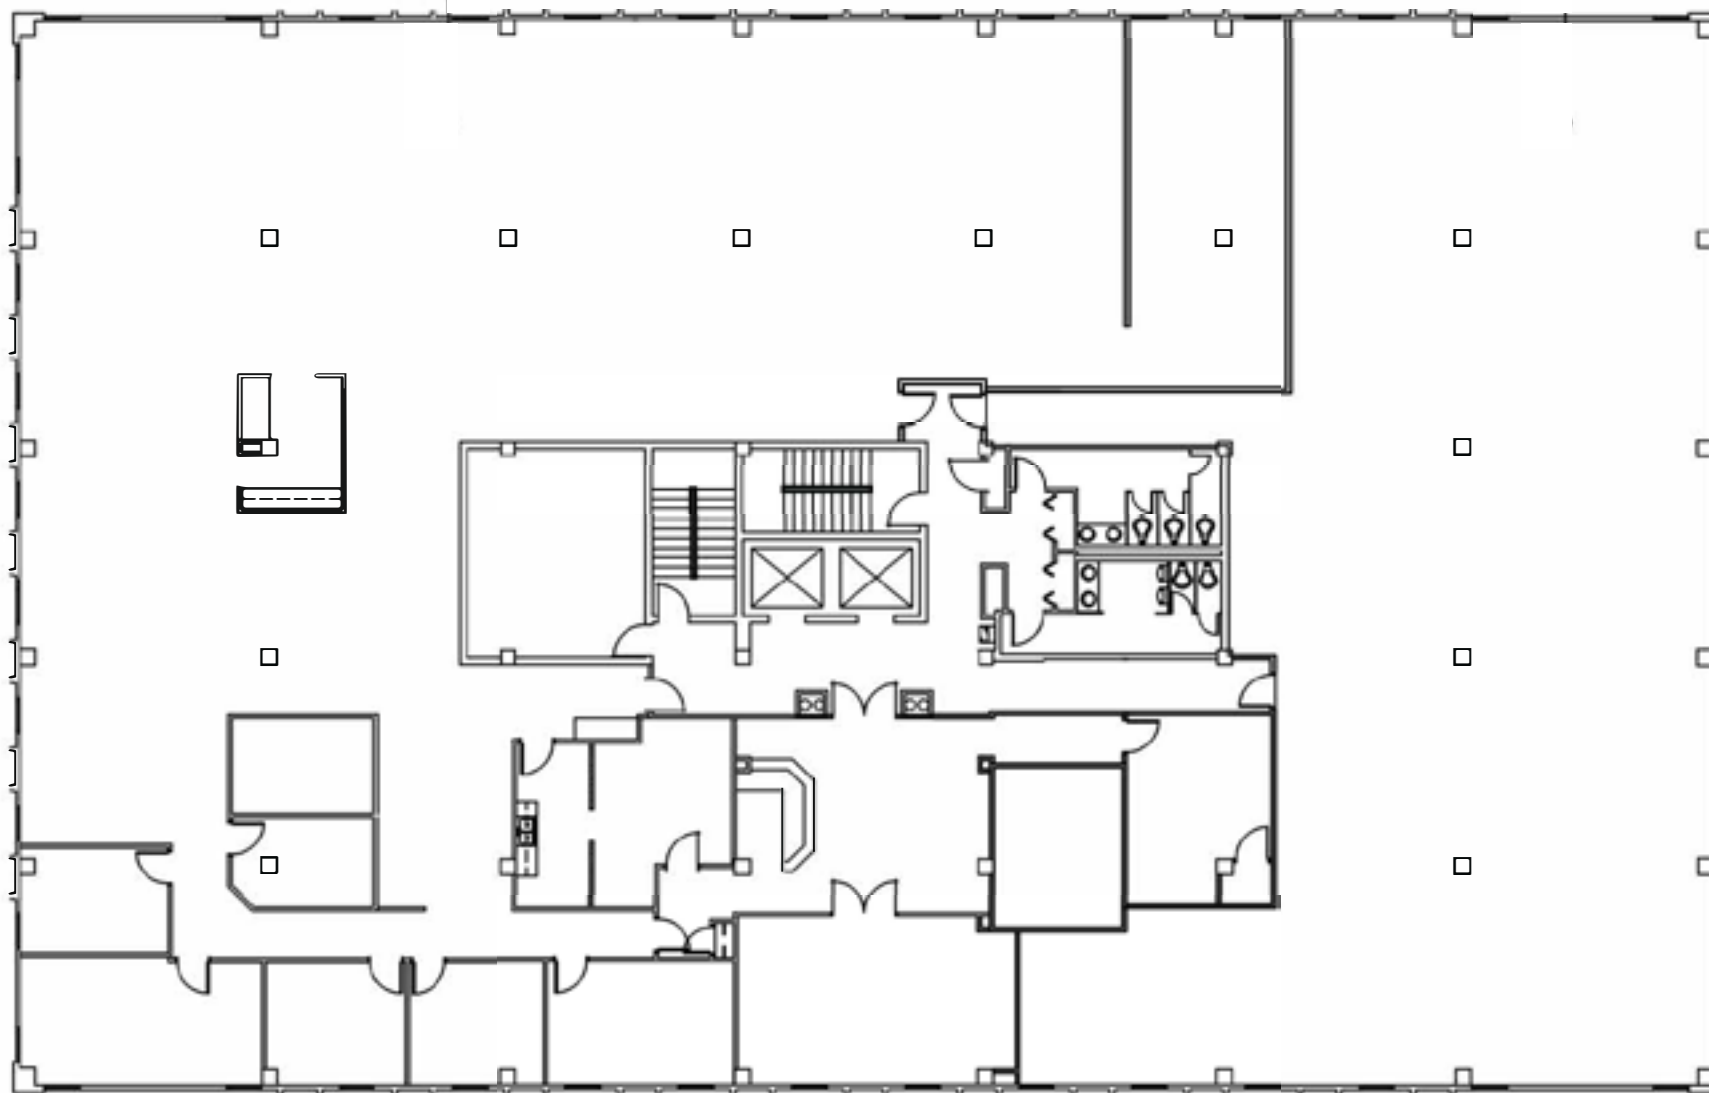

SCALE: NTS

AS-BUILT

THIRD FLOOR
9102 N. MERIDIAN ST. INDIANAPOLIS, IN

 PARALLEL DESIGN GROUP

2015.509

05.26.22