





# CENTER POINT I

3900 E Mexico Avenue,  
Denver, CO 80210

## SUITE 900 5,473 RSF

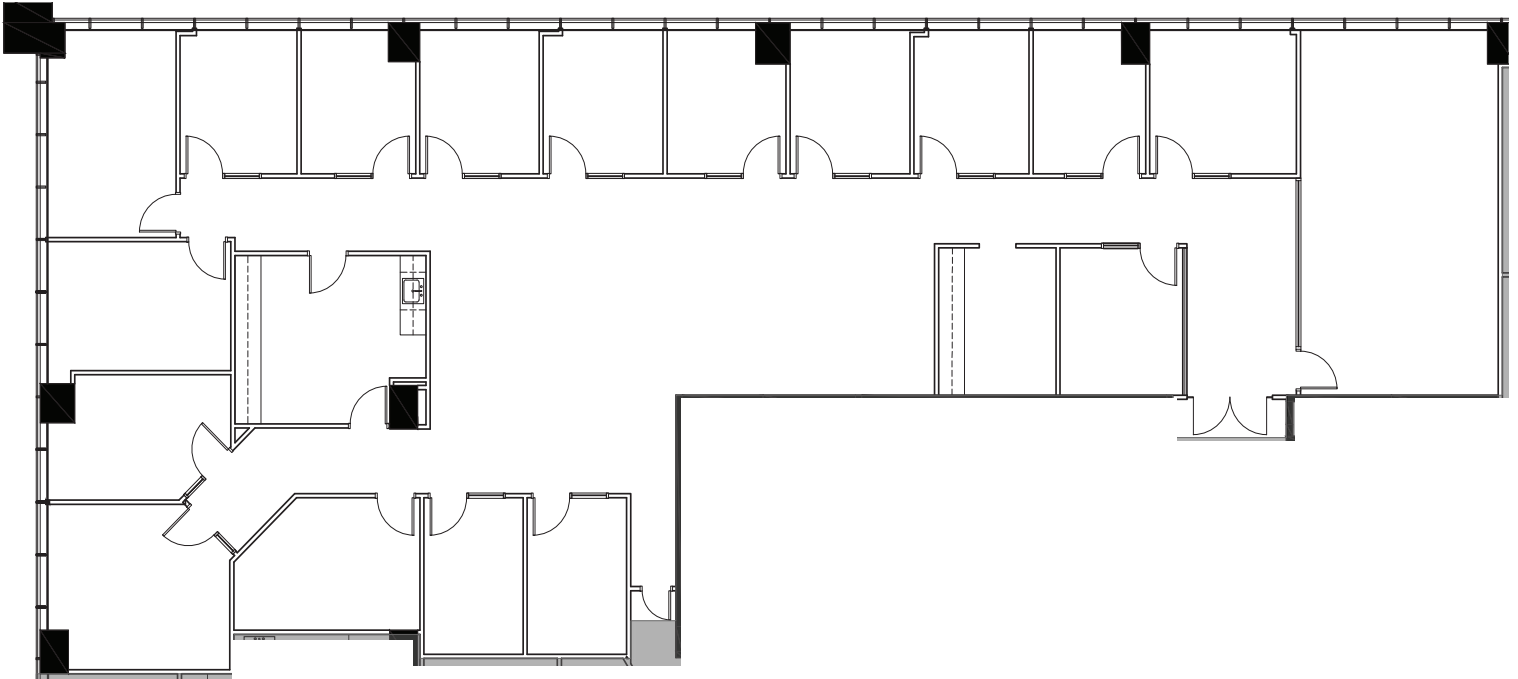

### Key:

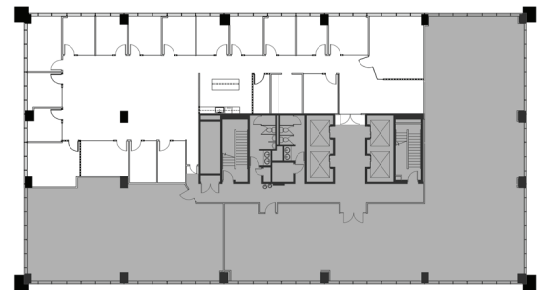

W. Ryan Stout  
303.813.6448  
ryan.stout@cushwake.com

Zachary T. Williams  
303.813.6474  
zach.williams@cushwake.com

Caitlin I. Ellenson  
303.312.1914  
caitlin.ellenson@cushwake.com

