

FOR LEASE

EL DORADO CLASS A OFFICE BUILDING

2950 E. Goldstone Drive, Meridian, Idaho 83642



30,183 SF Available | Divisible





PROPERTY HIGHLIGHTS

Building Size:	30,183 SF Can Demise To 5,968
Lease Rate:	\$16.50/SF
Lease Type:	NNN
Year Built:	2003
Lot Size:	2.686 Acres
Zoning:	C-C
Parcel Number:	R1022760250


LISTING FEATURES

- **Well-Maintained, Class A Single-Story Office Building**
 - Impeccably maintained with no deferred maintenance, offering an attractive and professional presence.
- **Flexible, Efficient Layout**
 - Designed for maximum adaptability, the layout includes private offices, open areas for cubicles, and a central core featuring restrooms, a mail room, breakroom, and a dedicated training room
- **Security Infrastructure in Place**
 - Equipped with a secure front entrance controlled from the receptionist area.
 - Both doors from the reception area feature electronic access control for enhanced security.
- **Robust Connectivity**
 - Redundant fiber connections available, ensuring reliable and high-speed internet access.
- **Excellent Access and Visibility**
 - Conveniently located off Eagle Road with a traffic light at the entrance. Multiple access points to the El Dorado Business Campus from both Overland Road and Eagle Road provide easy ingress and egress.
- **Parking**
 - Features ample parking of 122 spaces total, with a 4.04/1,000 parking ratio.




FLOOR PLANS

AS-BUILT FLOOR PLAN

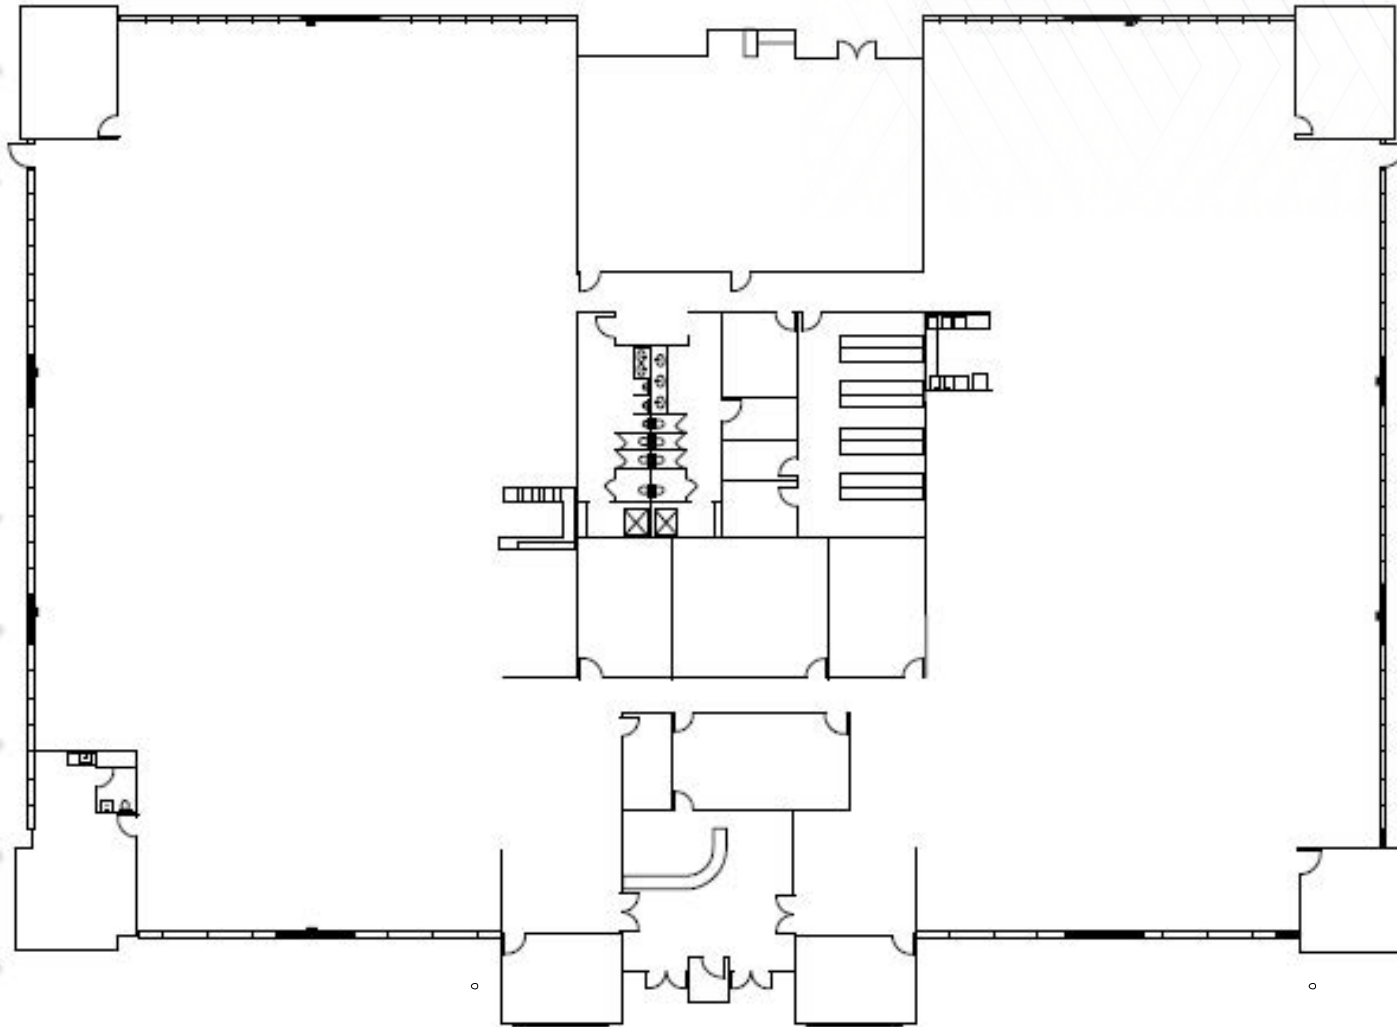


FLOOR PLANS

CONCEPTUAL DEMISED FLOOR PLAN

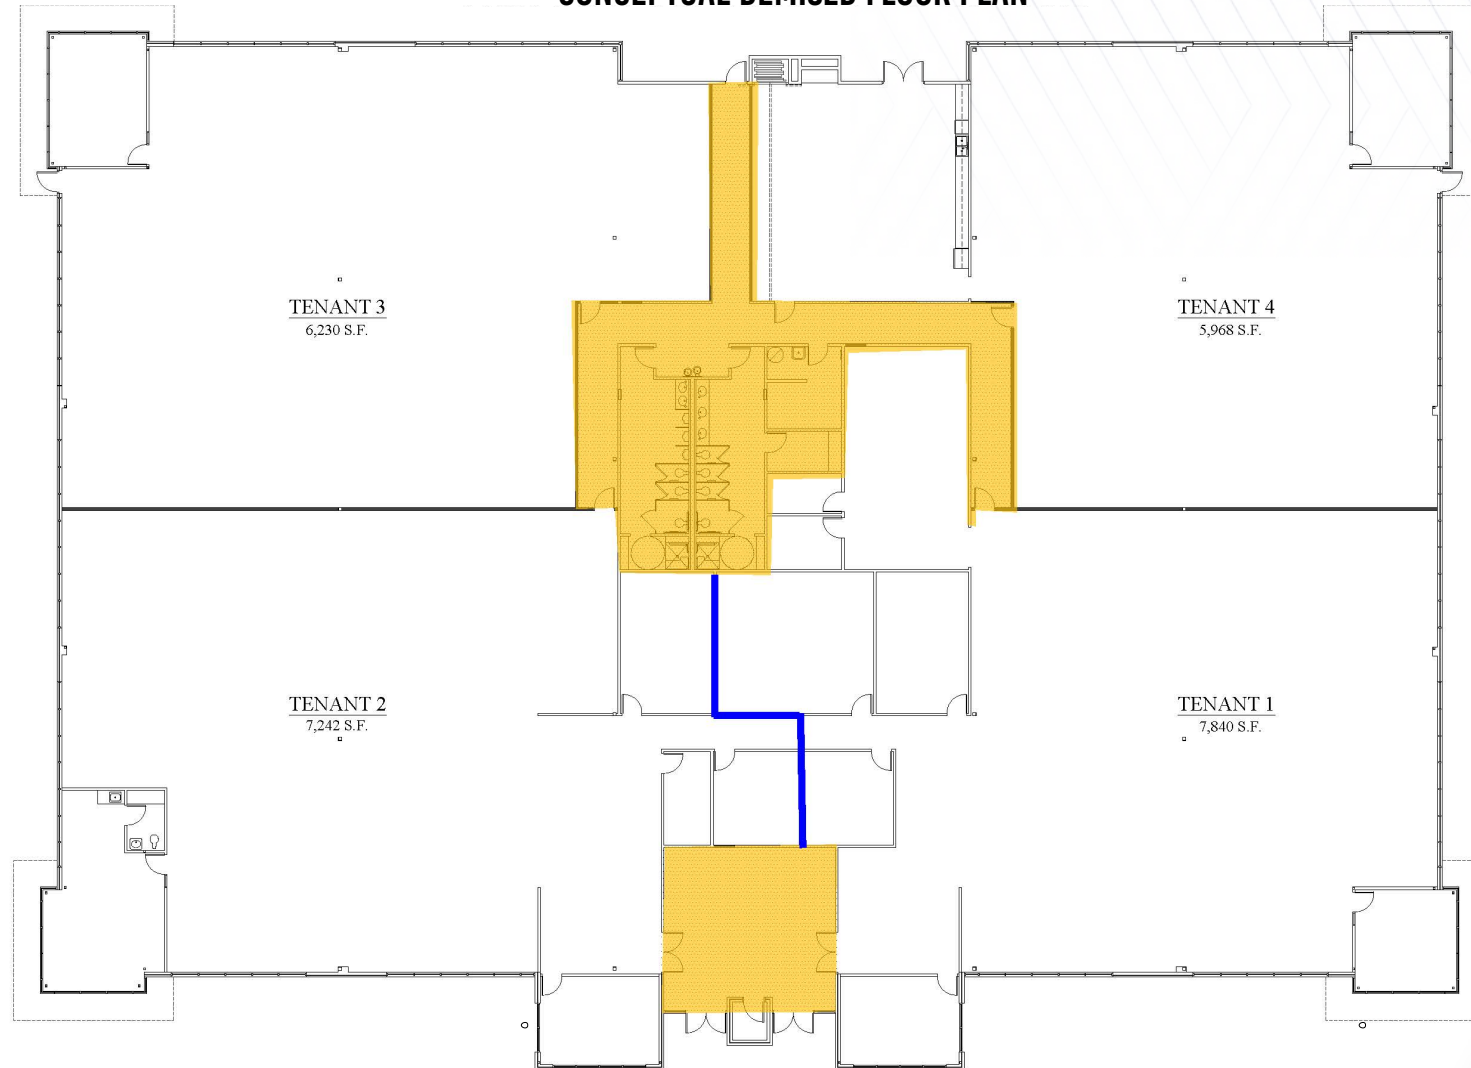


TENANT 1 AREA: 7,840 S.F.
TENANT 2 AREA: 7,242 S.F.
TENANT 3 AREA: 6,230 S.F.
TENANT 4 AREA: 5,968 S.F.
COMMON AREA: 2,651 S.F.
TOTAL BLDG. AREA: 29,931 S.F.

VICINITY MAP

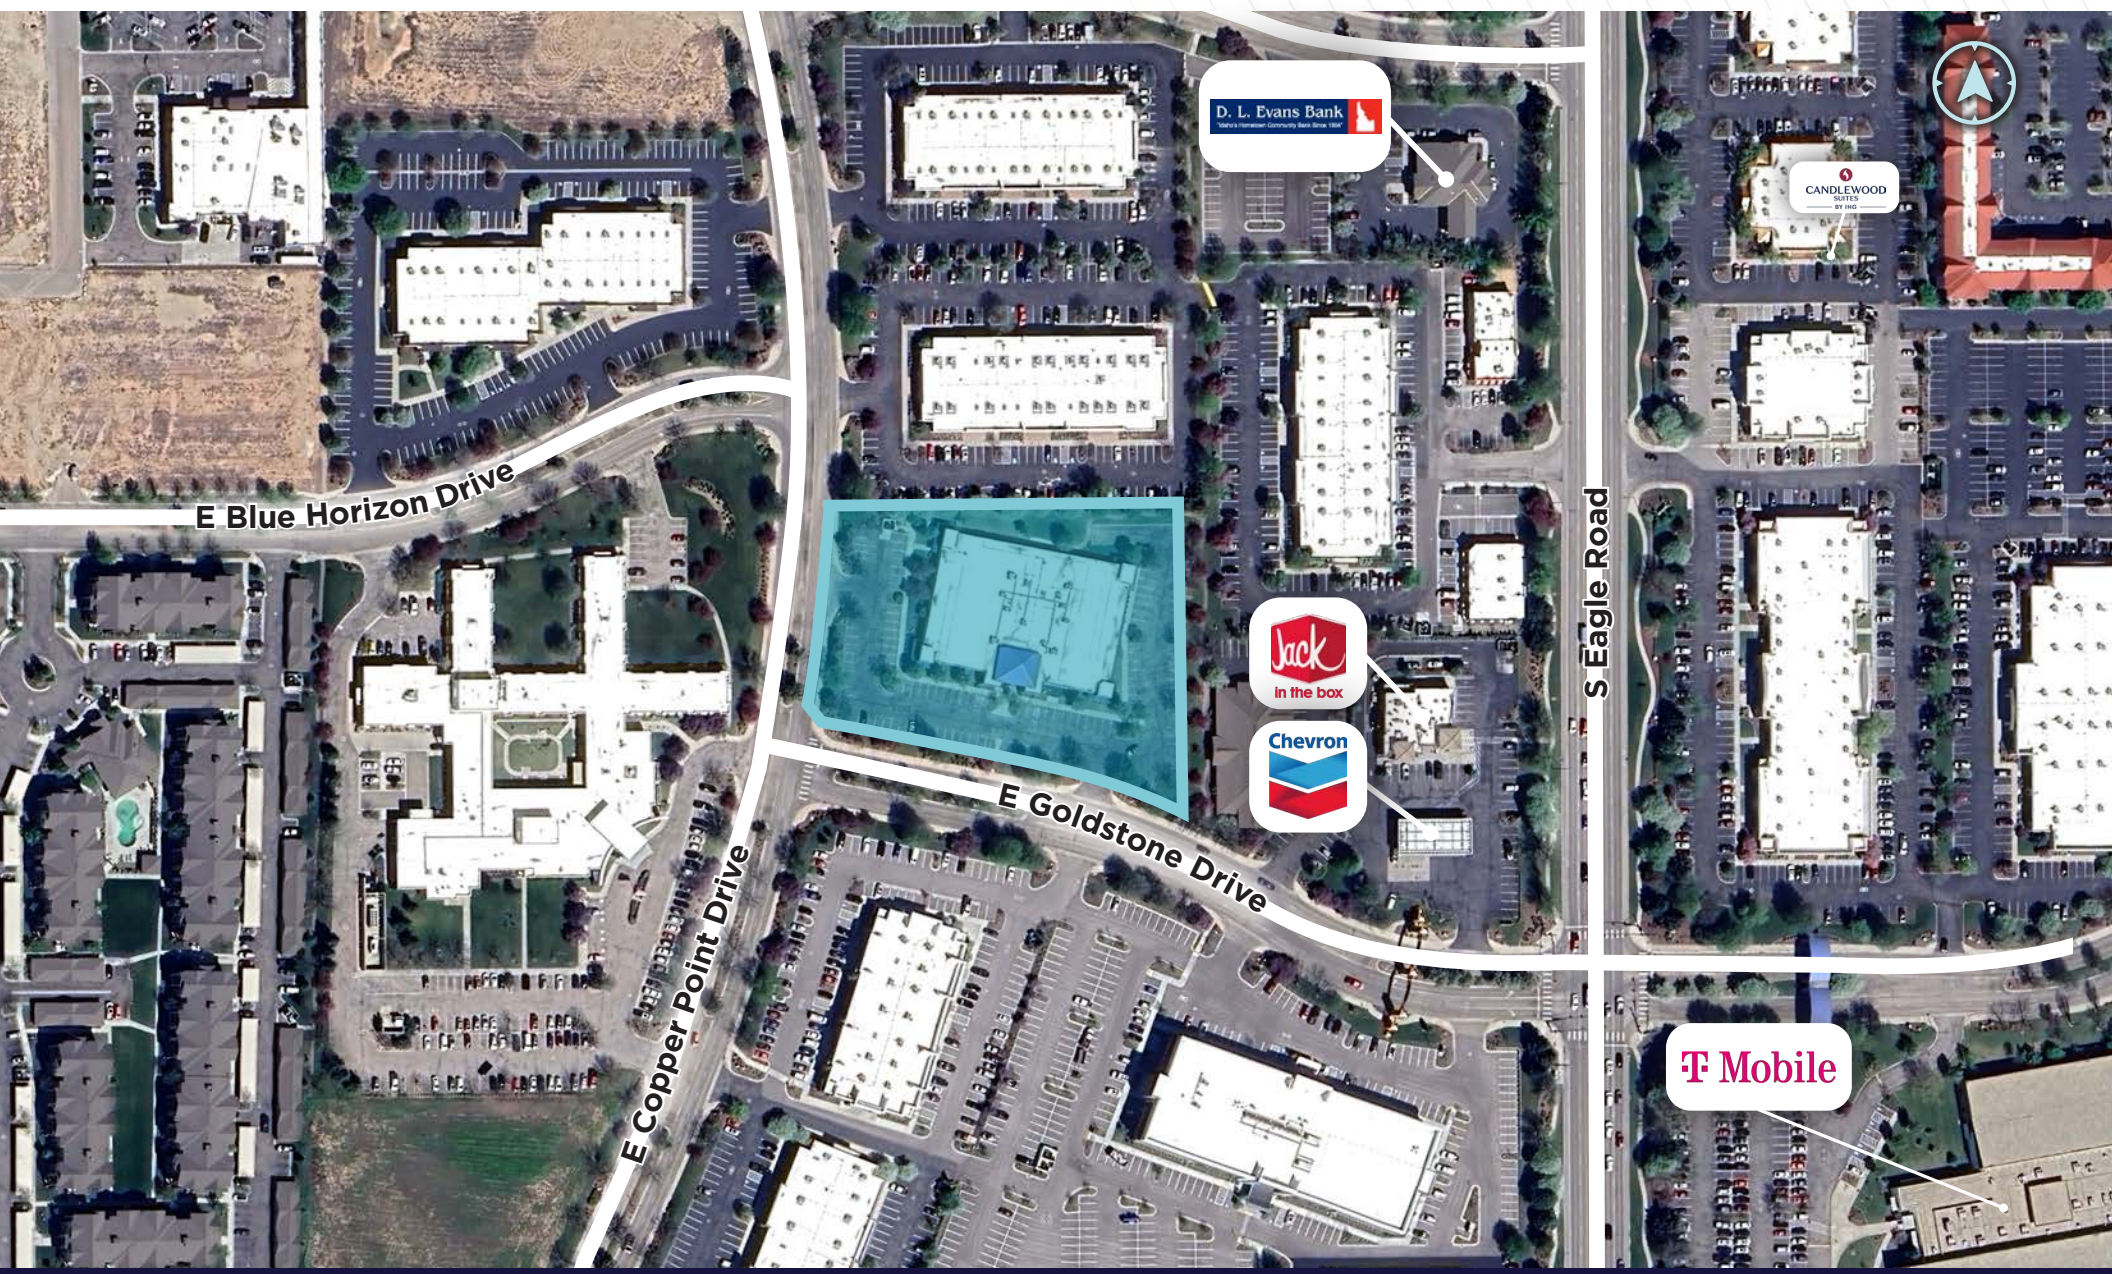

VICINITY MAP

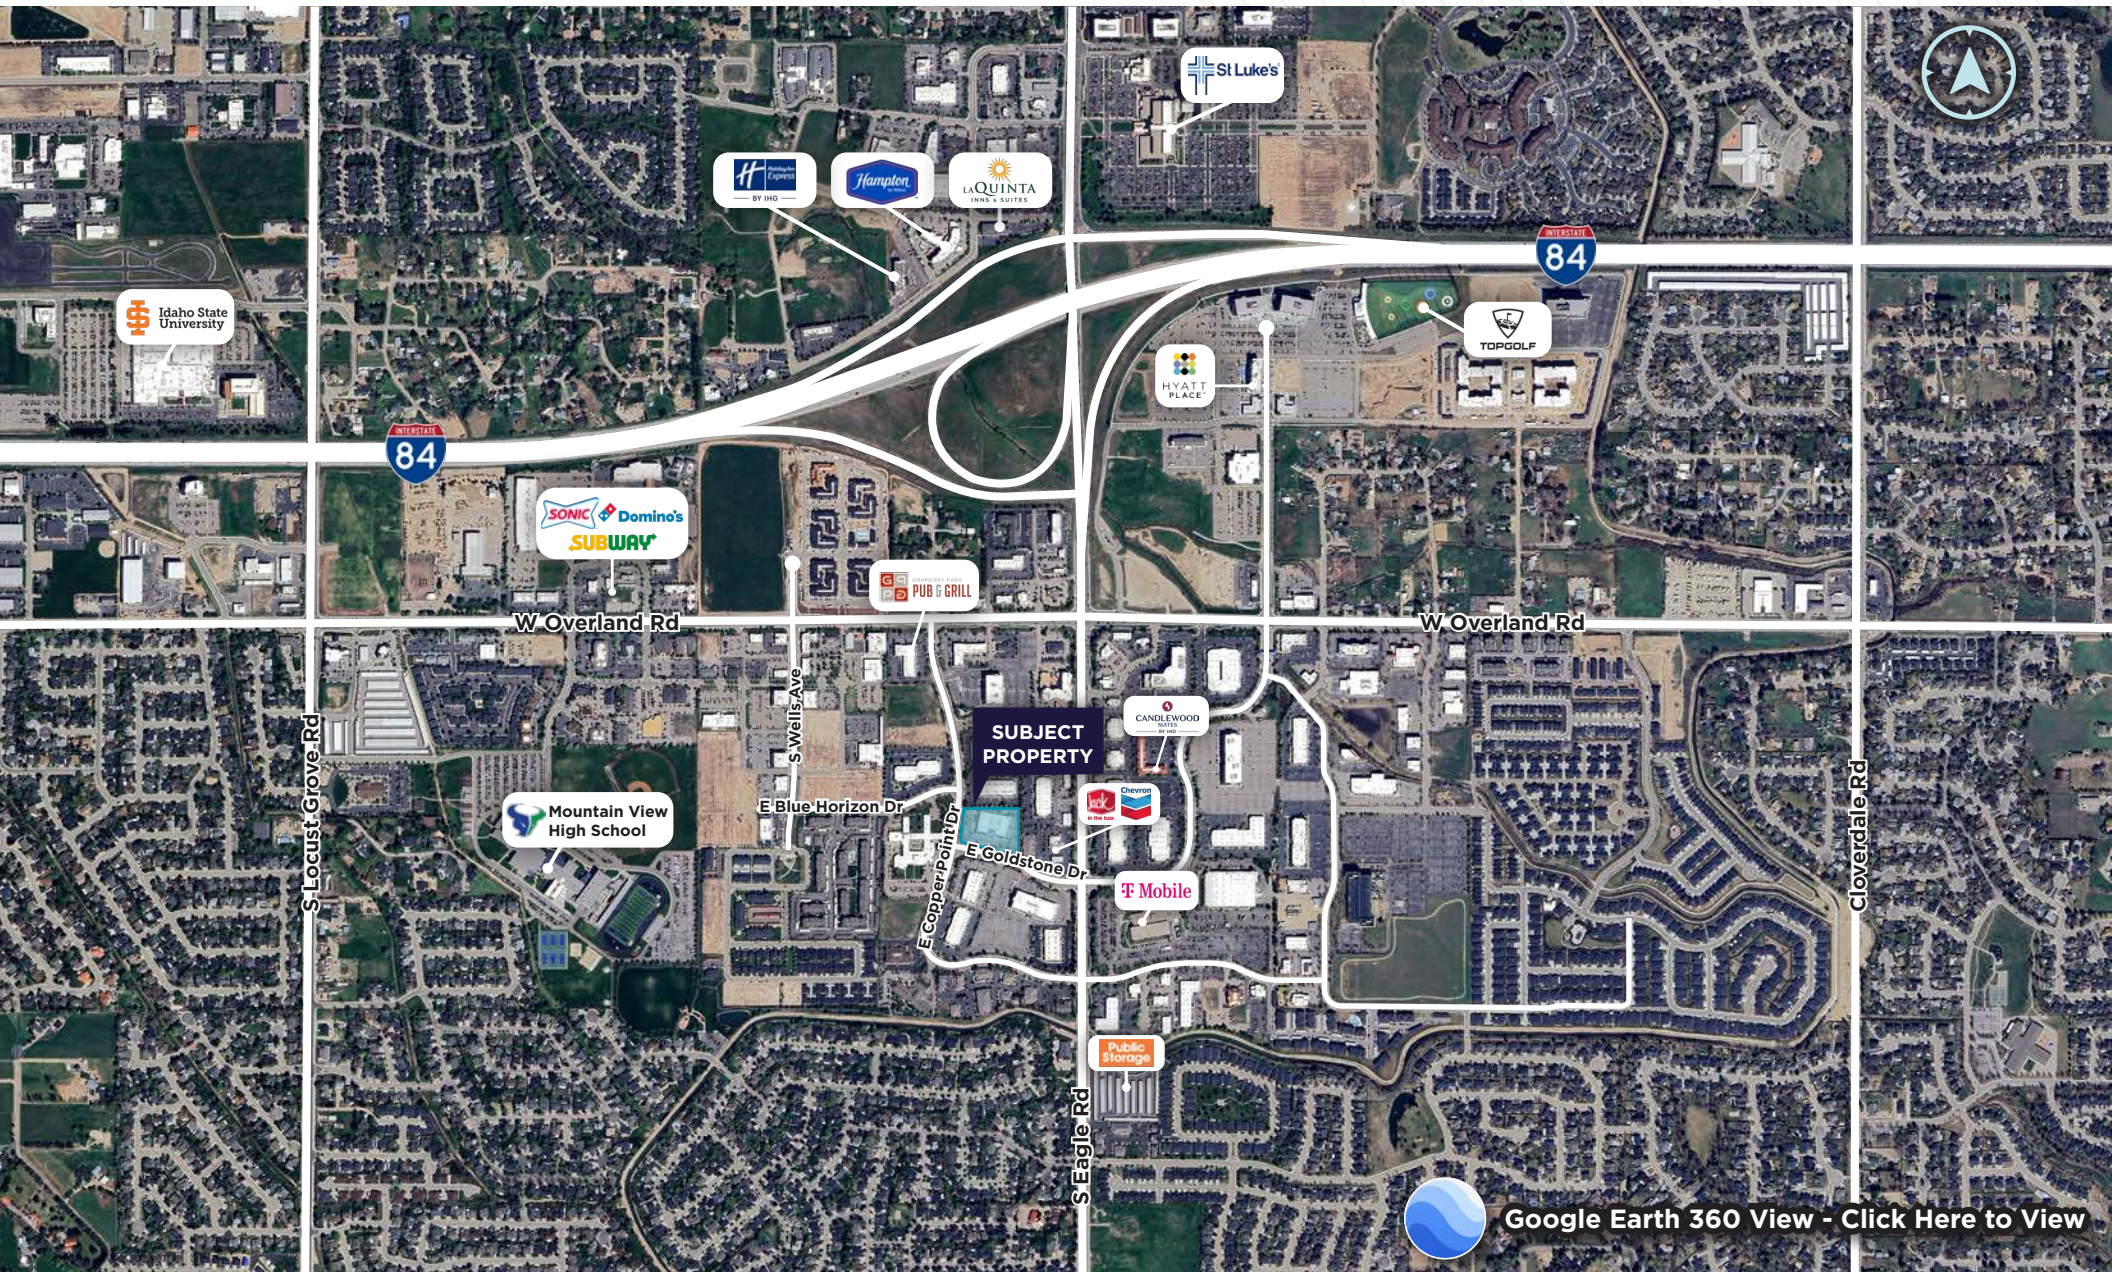



CONTACT INFO

DAVE WINDER, CCIM

Director

Direct: +1 208 287 9498

dave.winder@cushwake.com

999 W Main Street
Suite 1300 Boise, ID 83702
Direct +1 208 287 9500
cushmanwakefield.com



©2025 Cushman & Wakefield. All rights reserved. The information contained in this communication is strictly confidential. This information has been obtained from sources believed to be reliable but has not been verified. NO WARRANTY OR REPRESENTATION, EXPRESS OR IMPLIED, IS MADE AS TO THE CONDITION OF THE PROPERTY (OR PROPERTIES) REFERENCED HEREIN OR AS TO THE ACCURACY OR COMPLETENESS OF THE INFORMATION CONTAINED HEREIN, AND SAME IS SUBMITTED SUBJECT TO ERRORS, OMISSIONS, CHANGE OF PRICE, RENTAL OR OTHER CONDITIONS, WITHDRAWAL WITHOUT NOTICE, AND TO ANY SPECIAL LISTING CONDITIONS IMPOSED BY THE PROPERTY OWNER(S). ANY PROJECTIONS, OPINIONS OR ESTIMATES ARE SUBJECT TO UNCERTAINTY AND DO NOT SIGNIFY CURRENT OR FUTURE PROPERTY PERFORMANCE.