


North

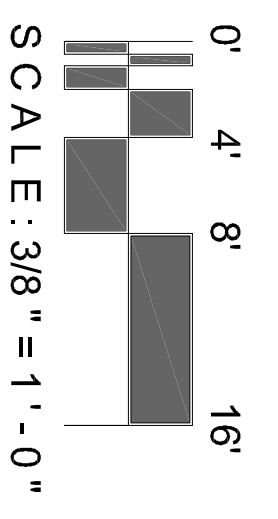

AUGUST 23, 2018

ORLANDO, FLORIDA

15233

1030 NORTH ORANGE AVE

AS BUILT

SUITE 220 FLOOR PLAN 1,800 R.S.F.

